

-14-

DRH 07 00393




Proposed Addition
West Elevation
scale 1/8" = 1'-0"

PLANNING & DEVELOPMENT
SERVICES

JUL 30 2007

RECEIVED

NOTE: Redline
screen & open porch
return posts to match
period details

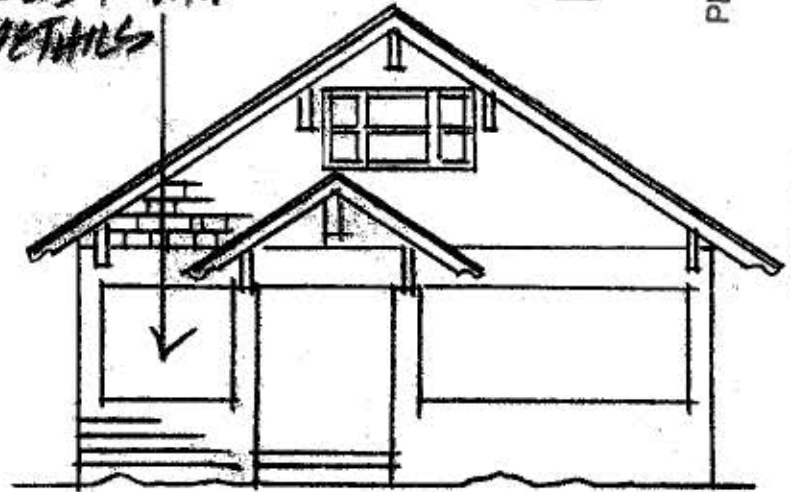


EAST ELEVATION
scale 1/8" = 1'-0"

RECEIVED

JUL 18 2008

PLANNING & DEVELOPMENT
SERVICES

DRH 08 00256

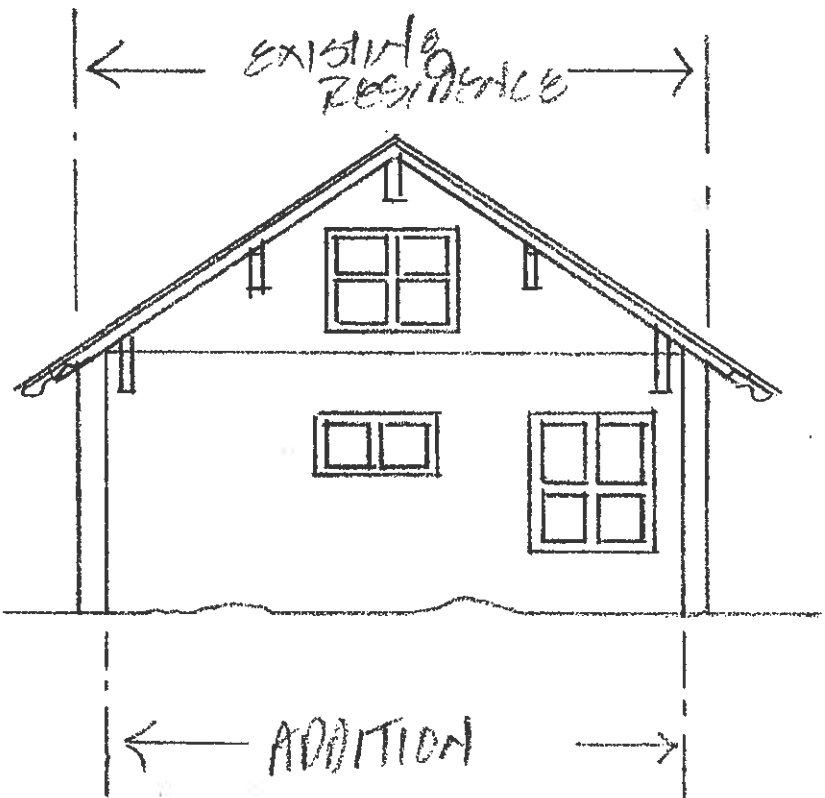

West elevation
SCALE 1/8" = 1'-0"

RECEIVED

JUL 18 2008


PLANNING & DEVELOPMENT
SERVICES

DRH 08 00256

ADDITION →

← EXISTING RESIDENCE

PROPOSED MATCHING
RIDGE/ROOF

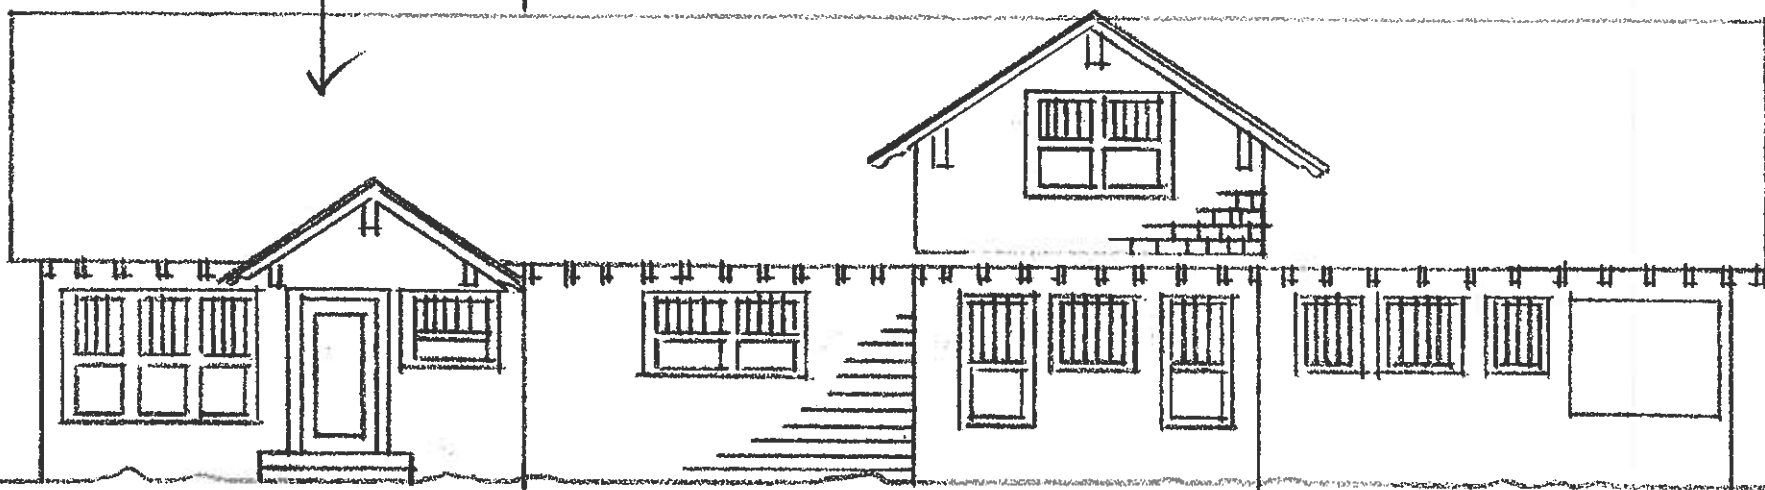

SOUTH ELEVATION
SCALE 1/8" = 1'-0"

DRH 08 00256

PLANNING & DEVELOPMENT
SERVICES


JUL 18 2008

RECEIVED

EXISTING RESIDENCE

← ADDITION

PROPOSED MATCHING
EAVE/ROOF

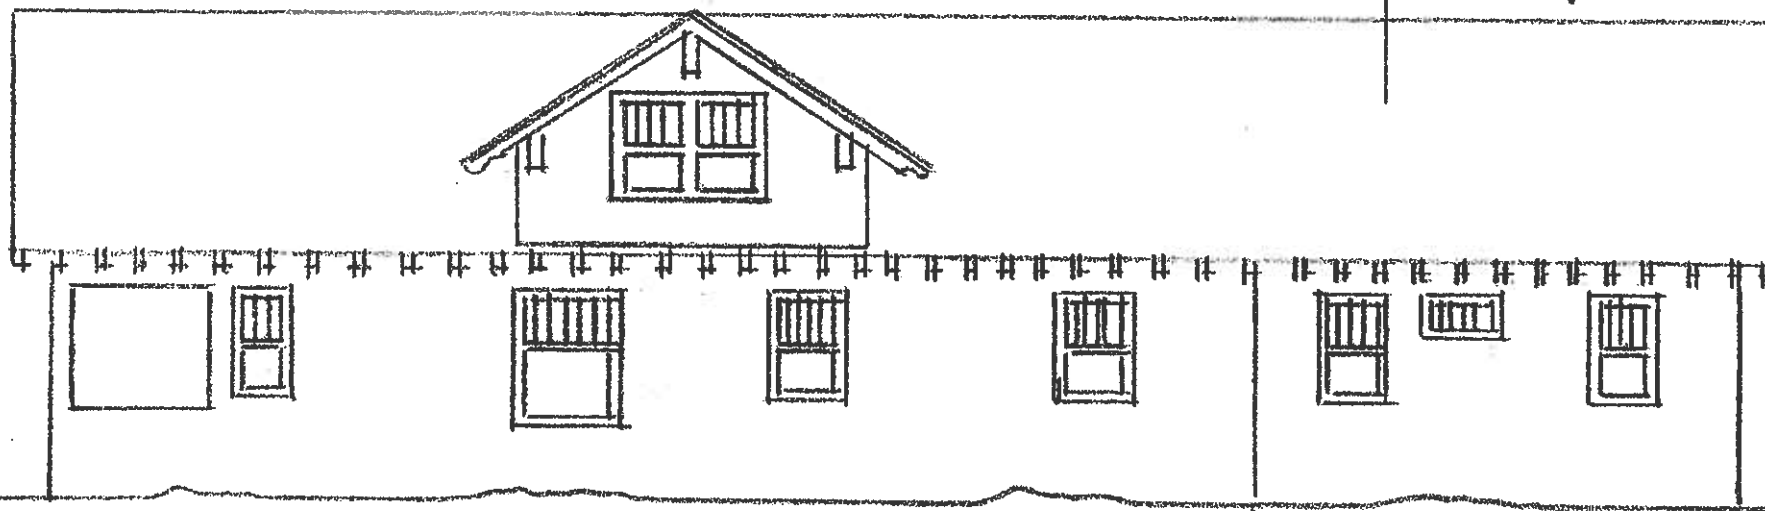

NORTH ELEVATION
SCALE 1/8" = 1'-0"

RECEIVED

JUL 18 2008

PLANNING & DEVELOPMENT
SERVICES

DRH 08 0.0256